


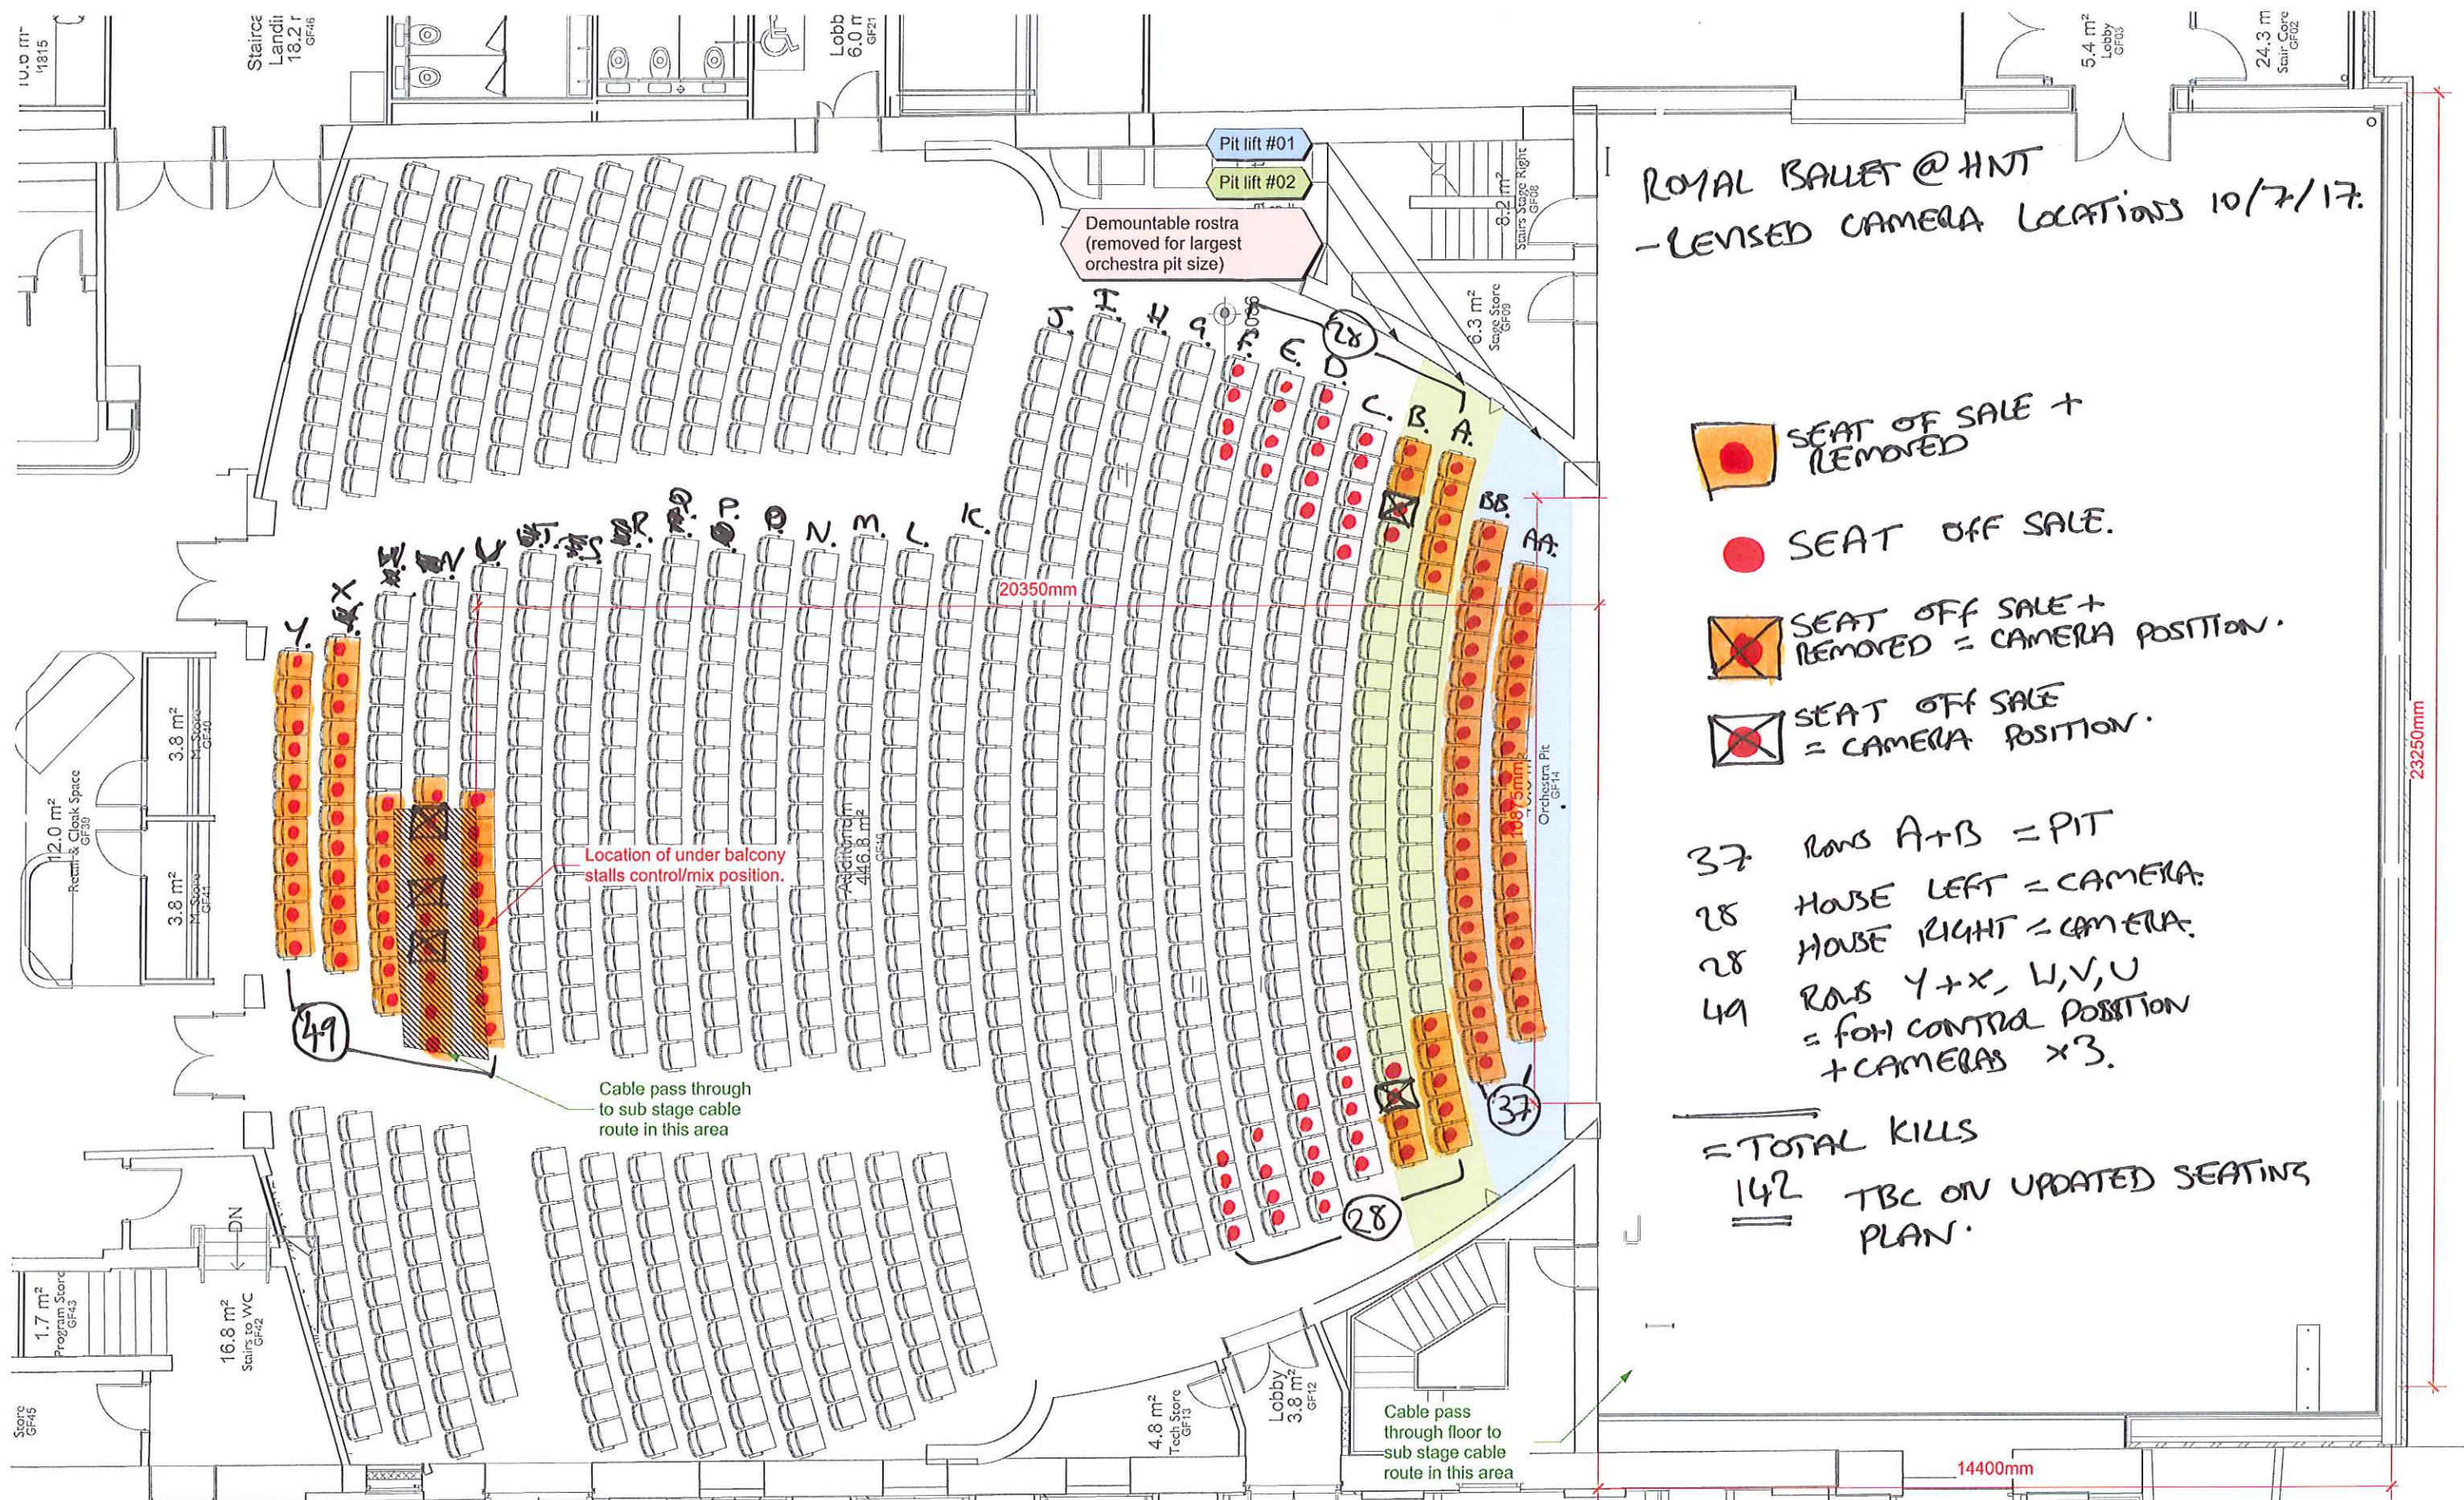

HULL NEW THEATRE STALLS

CONTACT: HULL NEW THEATRE TECHNICAL MANAGER:
 Kingston Square Hull HU1 3HF
 Tony Evans
 tony.evans@hullcc.gov.uk

Hull City Council
Hull Culture & Leisure

NOTES:
 Refer to technical specification for equipment schedules etc.

PRODUCTION:
 SCENE OR ACT:
 DIRECTOR:
 DESIGNER:
 PRODUCTION CONTACT:
AIDAN LESSER

LIGHTING:
 DRAWN BY:
 TOUR RELIGHTER:
 PLAN NAME/NUMBER/REVISION:
 SCALE: 1:75 @ A2
 0 1 2 3 4 5 M
 NOTE: provisional drawing. To be updated with as built plans.